Legal Delta

Re: kgarver: DEF57
Plotted 1/12/12 DS
Delta

State of California
State Water Resources Control Board
DIVISION OF WATER RIGHTS
1001 I Street, 14th Floor, Sacramento, CA 95814
P.O. Box 2000, Sacramento, CA 95812-2000
Info: (916) 341-5431, Fax: (916) 341-5400, www.waterboards.ca.gov/waterrights

WATER RESOURCES CONTROL BOARD
2011 JUN 20 AM 10: 20
DIV OF WATER RIGHTS

INITIAL STATEMENT OF WATER DIVERSION AND USE
NOTE: A Statement is not a Water Right

This Statement should be typewritten or legibly written in ink and submitted to the address above.
A separate statement must be filed for each point of diversion.

An (*) indicates a required section. Required sections must be completed for the Statement to be accepted.

***A.** Claimant/Agent Information POD SJ POU APN 191-300-160

Claimant/Owner: Long Brothers Family L.P. etal	Agent:
Mailing Address 790 French Camp Road	Mailing Address
Stockton, CA 95206	
William Long Henry Long	
Phone No. 209-982-0896 209-982-1356	Phone No.
Fax No.	Fax No.
E-mail Address:	E-mail Address:

***B.** Water is diverted and used under the claim of: Riparian claim ☒ Pre 1914 claim ☒ Court Decree No _____
Note, if you have an application on file for a water right or have an existing license, please provide your application number_____
Other (explain): _____

***C.** Name of the body of water at the point of diversion
San Joaquin River
Tributary to Sacramento-San Joaquin Delta

***D.** Point of diversion is located within San Joaquin County on Assessor's Parcel No. See attached
being within the _____ 1/4 of _____ 1/4 of Section _____, of Township _____, Range _____, _____ B&M.
Provide the location of the point of diversion using the California Coordinate System (NAD 1983) or Latitude / Longitude measurements.
See attached
Identify the point of diversion and outline the place of use on a United States Geological Survey (USGS) topographic map and submit the map with the Statement.

Name of the diversion works is _____ Related Water Right(s) _____

E. Do you own the land at the point of diversion? Yes ☒ No ☐ If No, please provide the name and address of the land owner at the point of diversion:_____

***F.** Capacity of diversion works 1.3 cfs (cfs, gpm, or gpd) Capacity of storage tanks or reservoir _____ (gallons or acre-feet)
Type of diversion facility: Gravity Creek Pump X Well Pump
Method of measurement: Weir Flume In line flow meter Electric Meter (Estimate)

NOTE: #Monthly report below is optional until January 1, 2012, at which time the information becomes mandatory.

#Provide the maximum rate of diversion achieved in each month in the table below as measured in: cfs gpm or gpd

Year	Jan	Feb	Mar	Apr	May	June	July	Aug	Sept	Oct	Nov	Dec

Additional copies of this form and water right information can be obtained at www.waterboards.ca.gov/waterrights.

S020891

Pod ID: 54701

*G. Provide the quantity of water diverted each month in the table below as measured in: Gallons Million gallons Acre-feet

Year	Jan	Feb	Mar	Apr	May	June	July	Aug	Sept	Oct	Nov	Dec	Total Annual

H. Annual water use in recent years: Maximum estimated 5 acre feet per acre (gallons or acre-feet) Minimum _____ (gallons or acre-feet)

State the year of first use at diversion site or storage facility 1800s

*I. Beneficial water use is for: (example, number of acres and type of crop irrigated, average number of persons served, number of stock watered, etc.) alfalfa

*J. General description and location of the place of use shall be identified using a USGS topographic map, or if assigned, may be provided using the public land description to the nearest 40 acre parcel accompanied by the County Assessor's parcel map.

See attached

K. Please answer only those questions below that are applicable to your project.

1. Conservation of water
   a. Describe any water conservation efforts you have in place Good Farming practices, concrete ditches, pipelines, all excess water is recycled to Delta channels
2. Water quality and wastewater reclamation
   a. Are you now or have you been using reclaimed water from a wastewater treatment facility, desalination facility or water polluted by waste to a degree that unreasonably affects such water for other beneficial uses? YES (NO)
3. Conjunctive use of surface water and groundwater
   a. Are you using groundwater in lieu of surface water? YES (NO)

I declare under penalty of perjury that the information in this report is true to the best of my knowledge and belief.

*DATE: 6-15-11 at Stockton, California

*SIGNATURE: Henry C Long

*PRINTED NAME: Henry (first name) C (middle initial) Long (last name)

COMPANY NAME: Long Brothers Family L.P.

GENERAL INFORMATION PERTAINING TO WATER RIGHTS IN CALIFORNIA

There are two principal types of surface water rights in California. They are riparian and appropriative rights.

A riparian right enables an owner of land bordering a natural lake or stream to take and use water on his riparian land. Riparian land must be in the same watershed as the water source and must never have been severed form the source of supply by an intervening parcel without reservation of the riparian right to the severed parcel. Generally, a riparian water user must share the water supply with other riparian users. Riparian rights may be used to divert the natural flow of a stream but may not be used to 1) store water for later use 2) divert water which originates in a different watershed 3) divert water released from storage, or 4) divert return flows from groundwater use.

An appropriative right is required for use of water on non-riparian land and for storage of water. Generally, appropriative rights may be exercised only when there is a surplus not needed by riparian water users. After the formation of the California Water Commission in December 1914, new appropriators have been required to obtain a permit or license from the State.

Statements of Water Diversion and Use must be filed by a riparian and/or pre-1914 appropriative water user. The filing of a statement 1) provides a record of water use, 2) enables the State to notify such users if someone proposes a new appropriation upstream from their diversion, and 3) assists the State in determining if additional water is available for future appropriators.

The above discussion is provided for general information. For more specific information concerning water rights, please visit the website http://www.waterboards.ca.gov/waterrights/water_issues/programs/diversion_use/, or write to this office.

Additional copies of this form and water right information can be obtained at www.waterboards.ca.gov/waterrights.

THIS MAP FOR ASSESSMENT USE ONLY 191-30

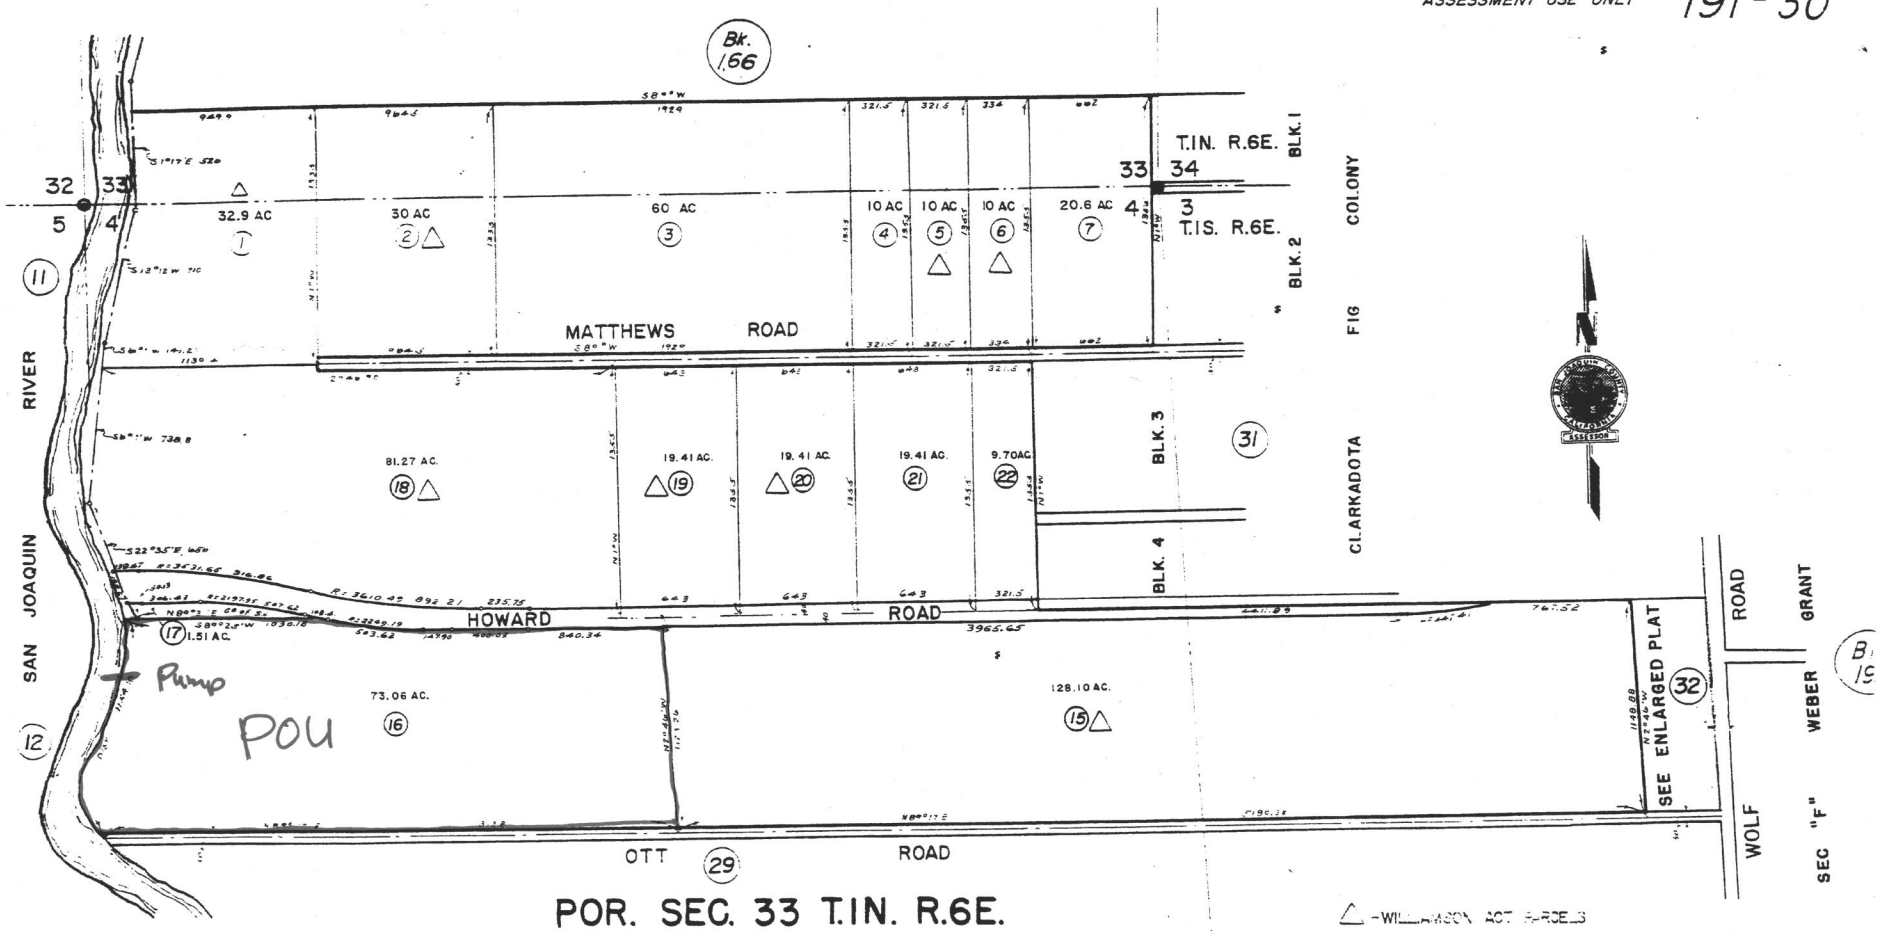

NOTE: SEE SURVEY "B" 53

POR. SEC. 33 T.1N. R.6E.
&
POR. SEC. 3 & 4 T.1S. R.6E.

SCALE 1"=600'
SAN JOAQUIN COUNTY
ASSESSORS MAPS

S020891

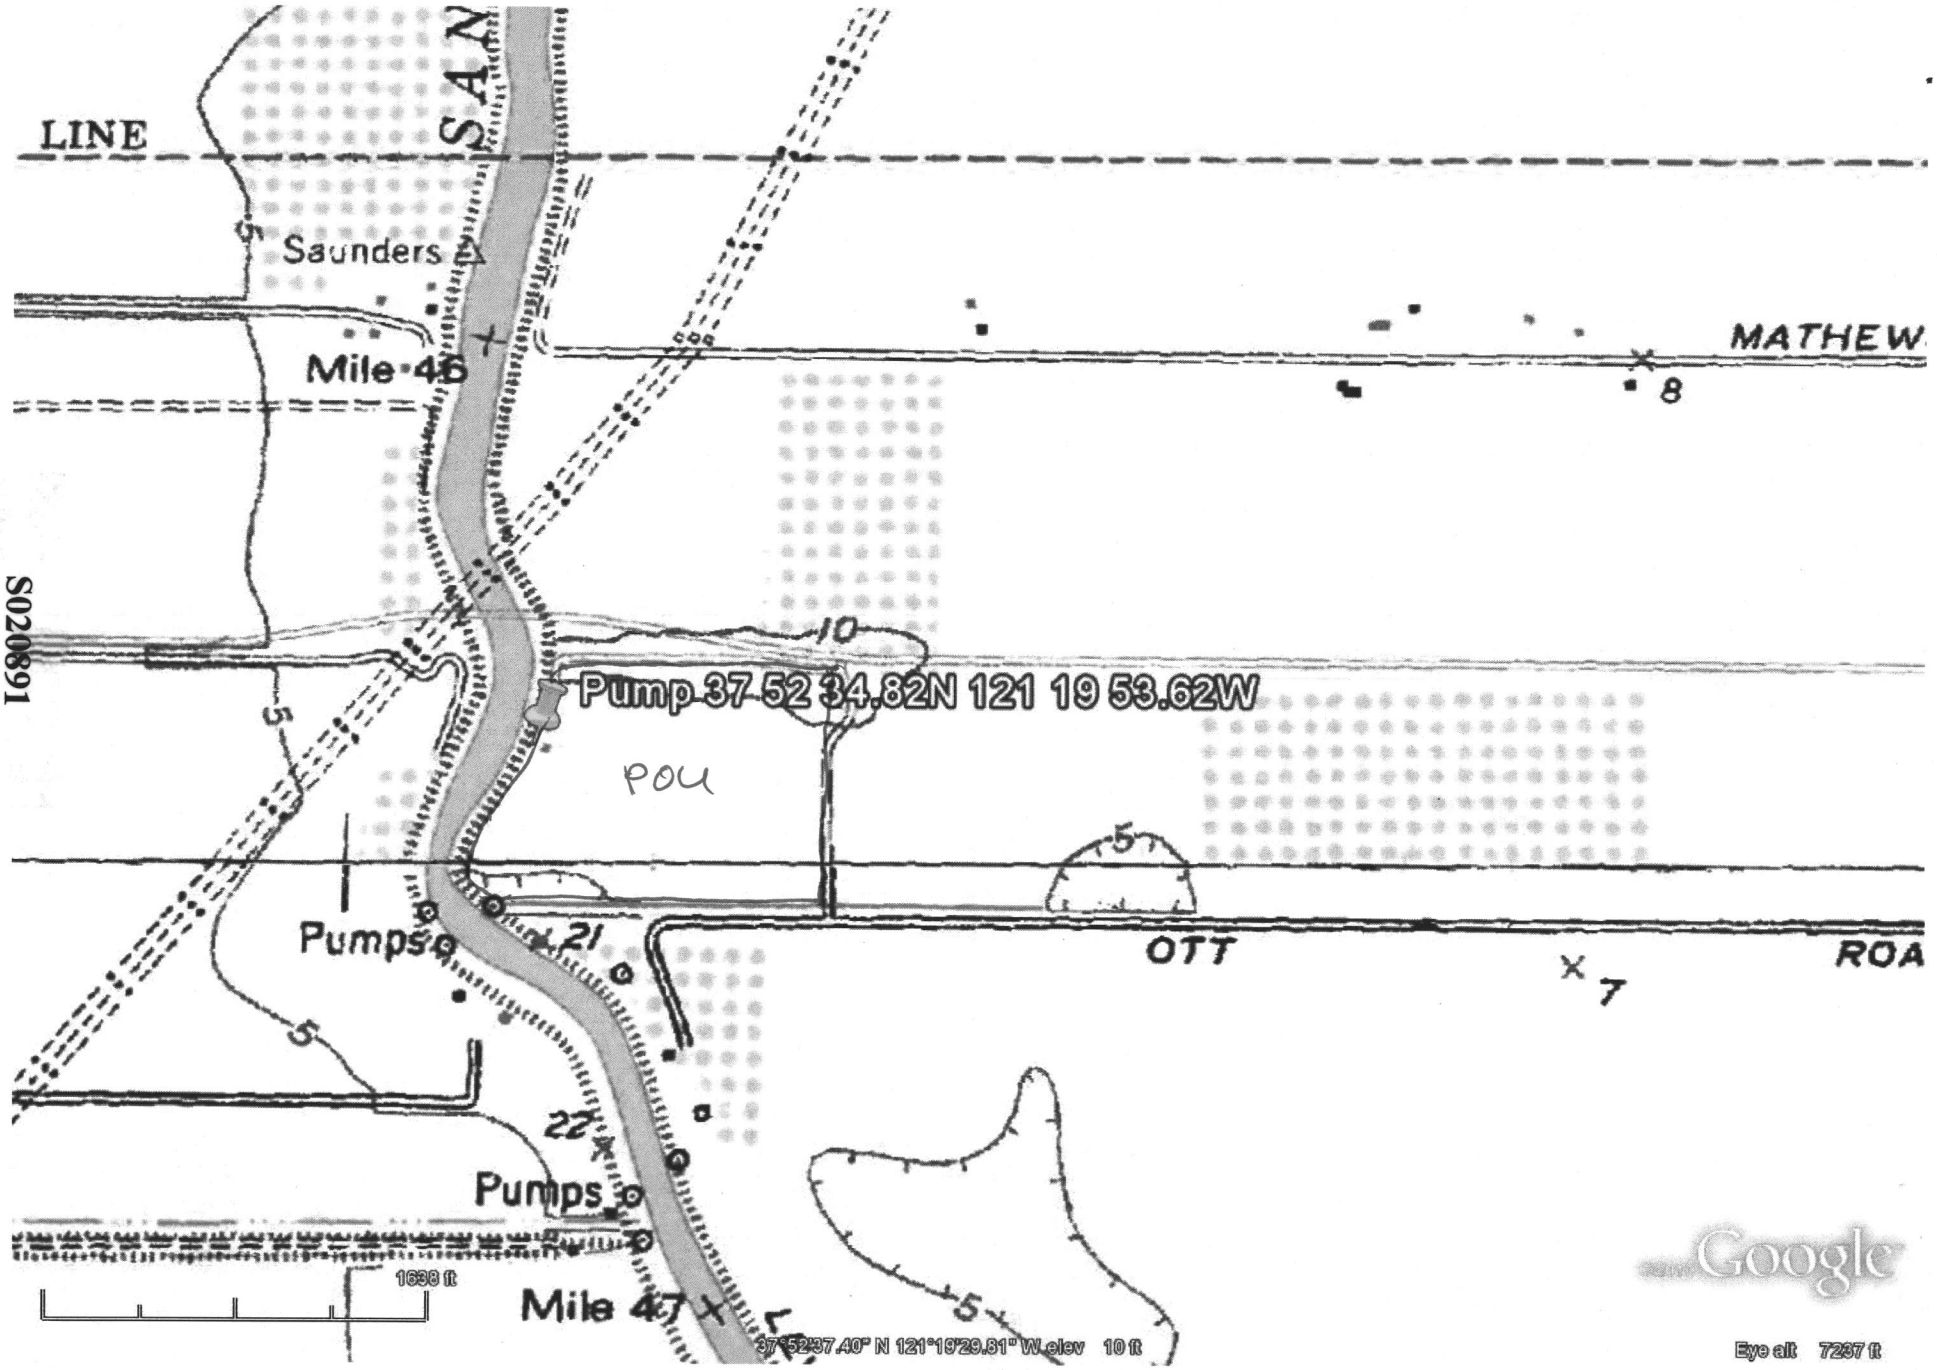
LINE
SAN
Saunders
Mile 46
MATHEW
8
10
Pump 37 52 34.82N 121 19 53.62W
POU
5
Pumps
21
OTT
ROA
7
22
Pumps
1638 ft
Mile 47
37°52'37.40" N 121°19'29.81" W elev 10 ft
Google
Eye alt 7237 ft

S020891

RJF / KLG

NOMELLINI, GRILLI & McDANIEL
PROFESSIONAL LAW CORPORATIONS

DANTE JOHN NOMELLINI
DAVID L. GRILLI
DANIEL A. McDANIEL
DANTE JOHN NOMELLINI, JR.

235 EAST WEBER AVENUE
POST OFFICE BOX 1461
STOCKTON, CALIFORNIA 95201-1461
TELEPHONE (209) 465-5883
FAX: (209) 465-3956

DANTE JOHN NOMELLINI
PROFESSIONAL LAW CORPORATION

DAVID L. GRILLI
PROFESSIONAL LAW CORPORATION

DANIEL A. McDANIEL
PROFESSIONAL LAW CORPORATION

June 16, 2011

DIV OF WATER RIGHTS
2011 JUN 20 AM 10:20

Certified
Return Receipt Requested

State Water Resources Control Board
Division of Water Rights
1001 I Street, 14th Floor
Sacramento, CA 95814

Re: Long Brothers Family L.P. et al.
kgarver: DEF 57

Dear Ladies and Gentlemen:

Enclosed herewith please find the following amended Statements of Water Diversion and Use:

1) POD SJ POU APN 191-300-160
2) POD SJ POU APNs 166-020-01 & 02, 193-050-06

Yours very truly,

DANTE JOHN NOMELLINI, SR.
Attorney for Long Brothers Family L.P. et al.

DJN:ju
Enclosures
cc: Long Brothers Family L.P.

S020891